

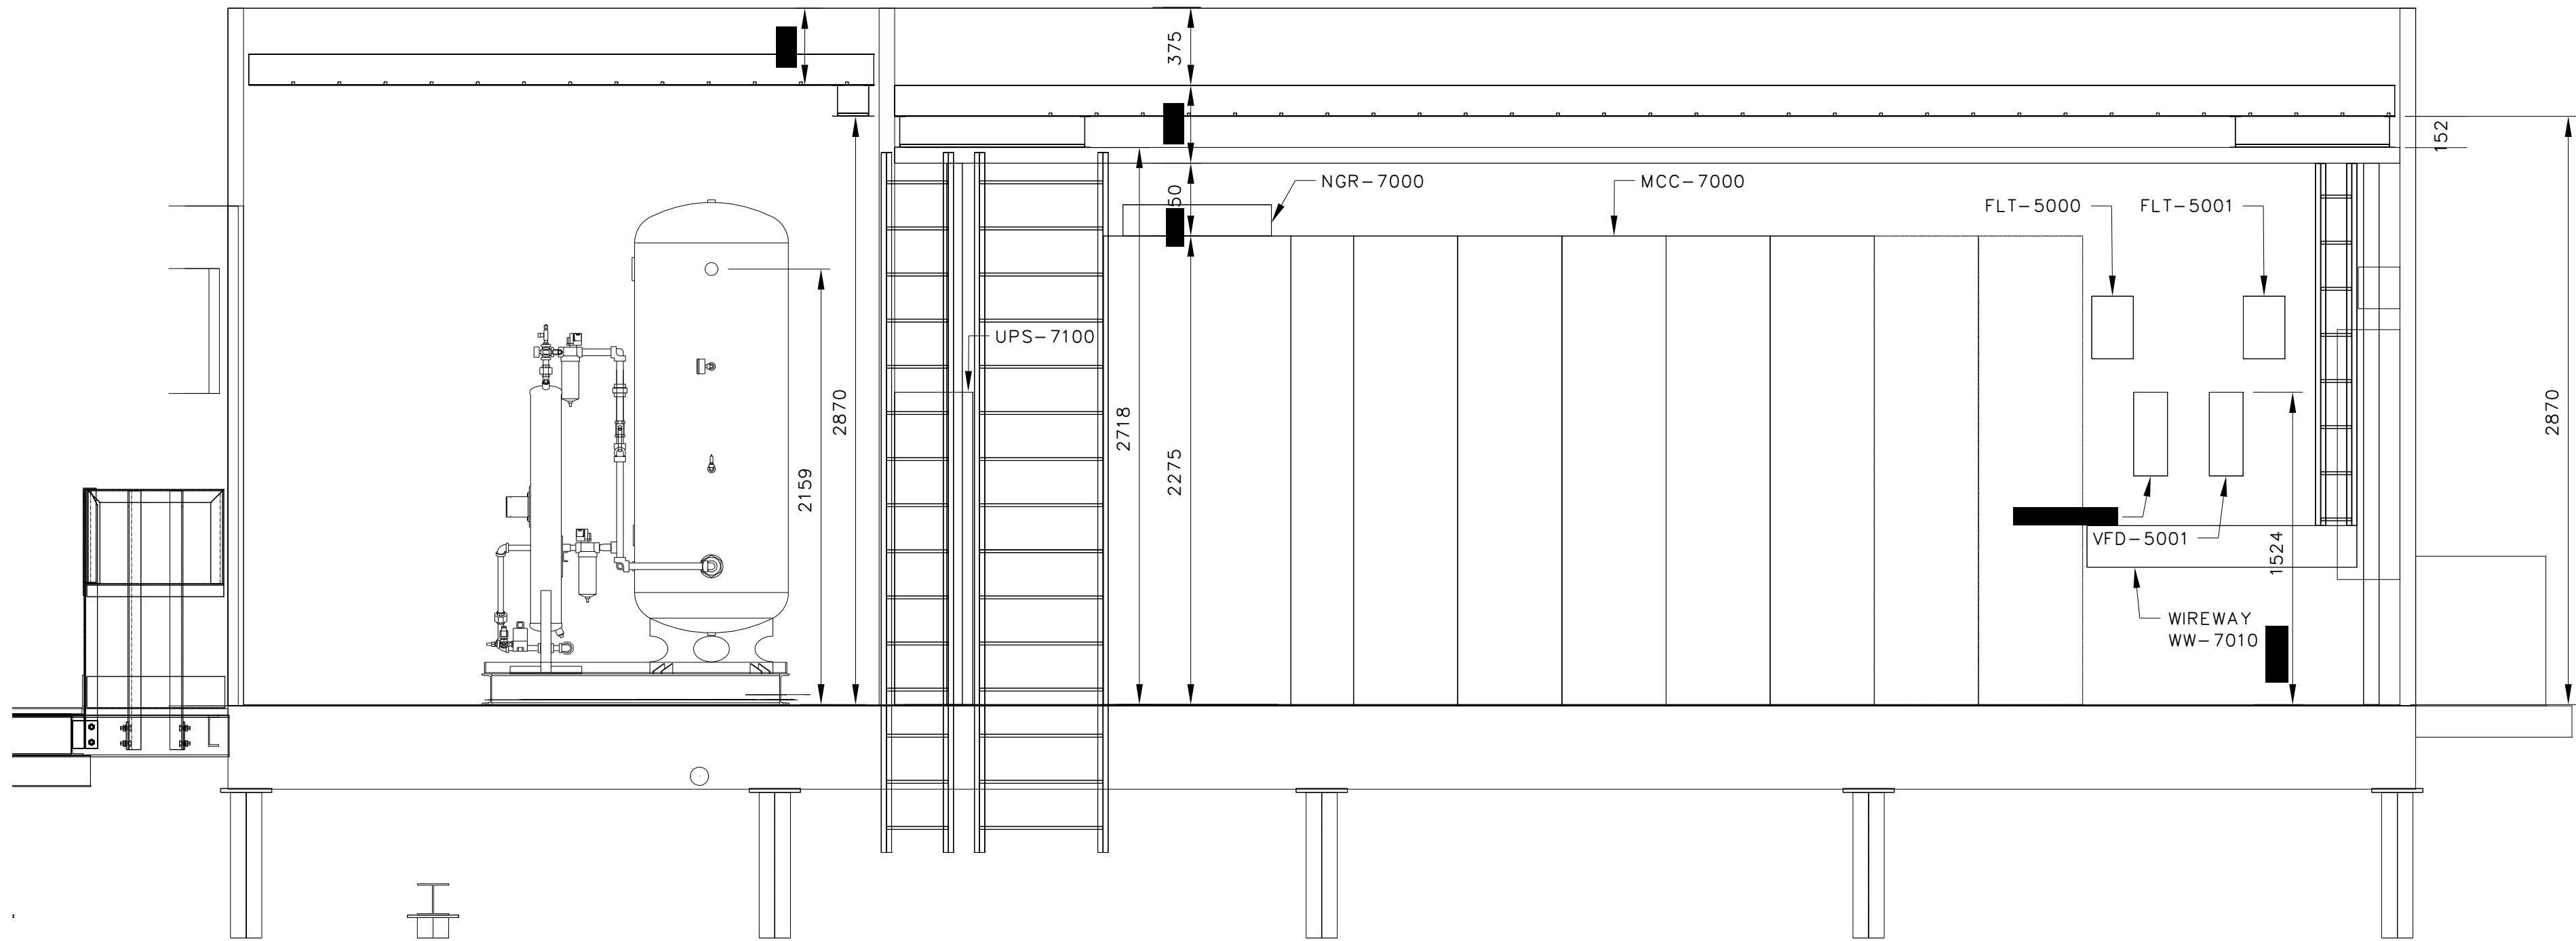


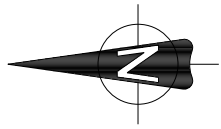

A
3111 SECTION

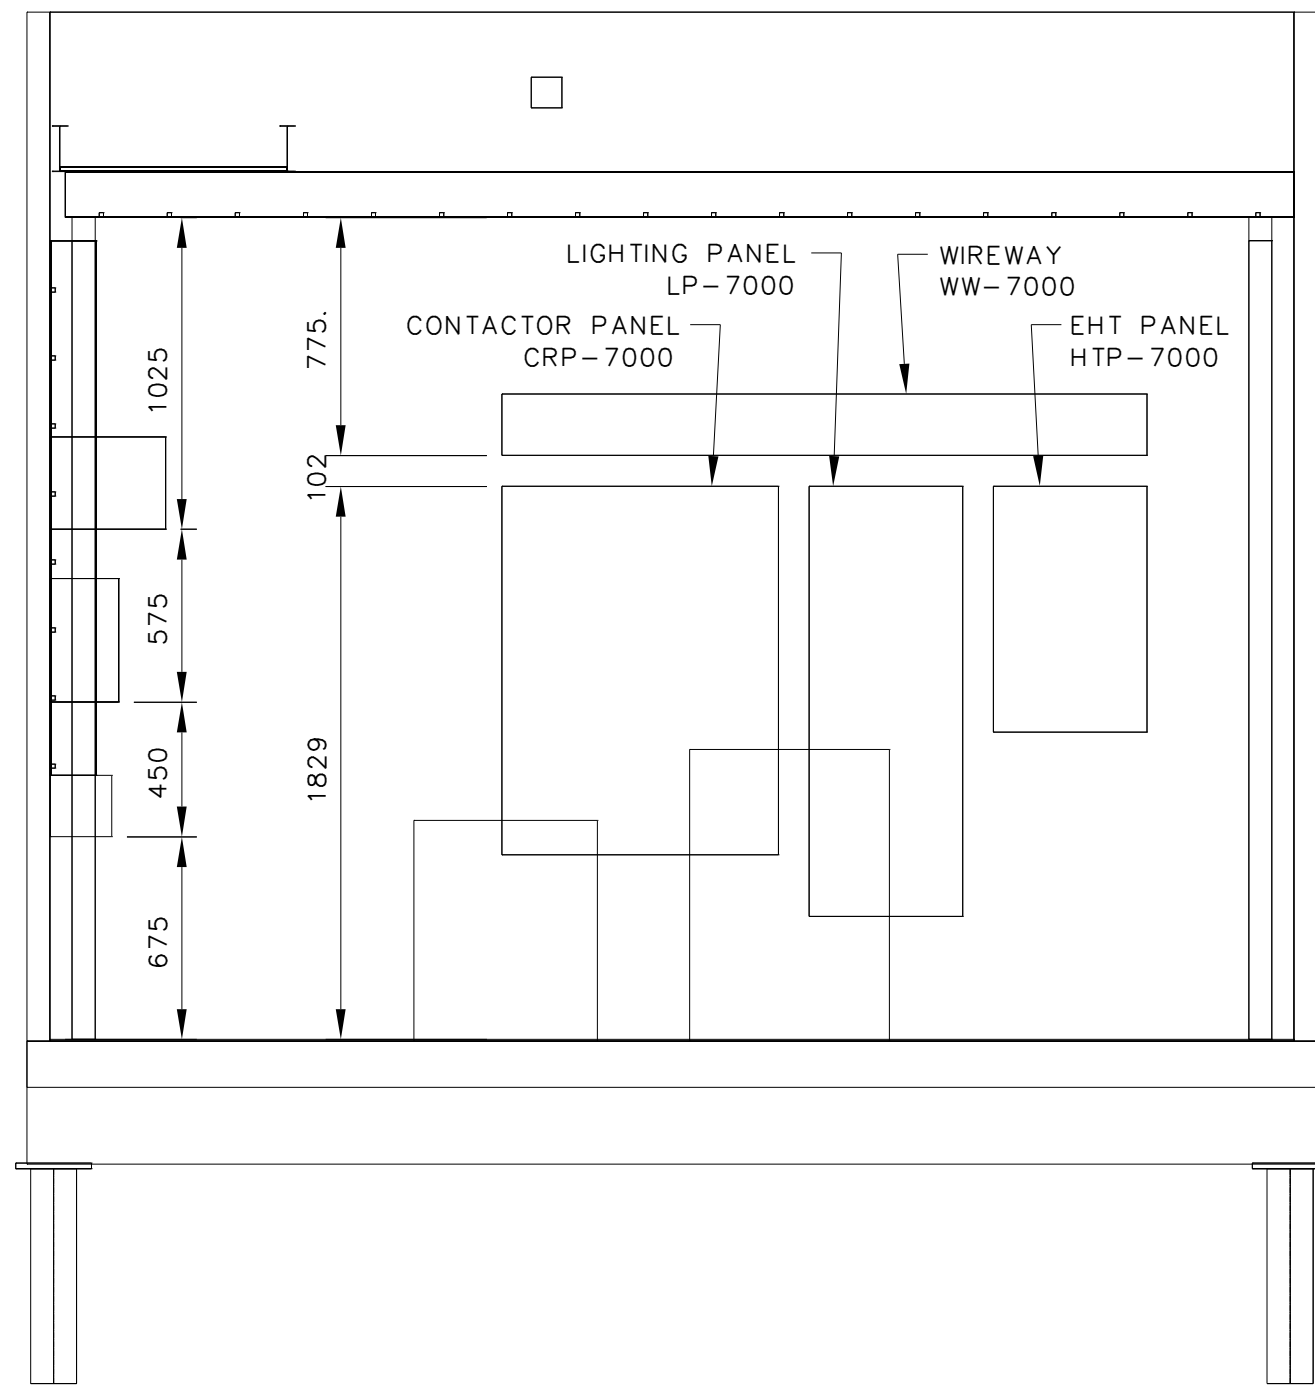

B
3111 SECTION

DWG. NO.	REFERENCE DRAWINGS	DEVON PROJECT	REV	REVISIONS	DATE (yy.mm.dd)	BY	CHK'D	APP'D	OWNR APP'D	ENGINEER AND PERMIT STAMPS	DESIGNED	DGA	10.07.12	devon KOMIE KOMIE d-87-G WELLSITE MCC BUILDING ELECTRICAL ELEVATIONS d-87-G/94-0-8			
											DRAWN	SS	10.07.12				
		1011815	4	AS-BUILT (ABB BM 369267)	11.01.11	LC	DA			REVISION 4 "AS-BUILT" BY: ABB BER-MAC PREVIOUS REVISION 3 BY: ABB BER-MAC PROFESSIONAL ENG.: M.J. SMITH PERMIT TO PRACTICE: P7119	CHECKED						
		1011815	3	IFC - FIELD CONSTRUCTION (ABB BM 369267)	10.11.10	SS	DA	MJS			PROCESS CK.						
		1011815	2	AS-BUILT - PACKAGE PREWIRE (ABB BM 369267)	10.11.02	SS	DA				MECH. CK.						
		1011815	1	IFB - FIELD CONSTRUCTION (ABB BM 369267)	10.10.19	SS	DA				STRUCT. CK.						
		1011815	0	IFC - PACKAGE PREWIRE (ABB BM 369720)	10.10.01	SS	DA	MJS			ELECT. CK.						
CADD FILE:											OWNER APP.			CONTR JOB NO	SCALE	DWG. NO.	DEVON PROJ.
											OWNER APP.			369267	1:25	D-1011815-3112	1011815

