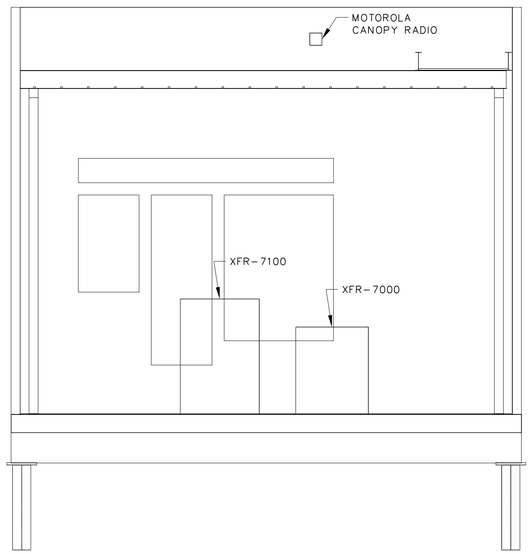

C
3111
SECTION

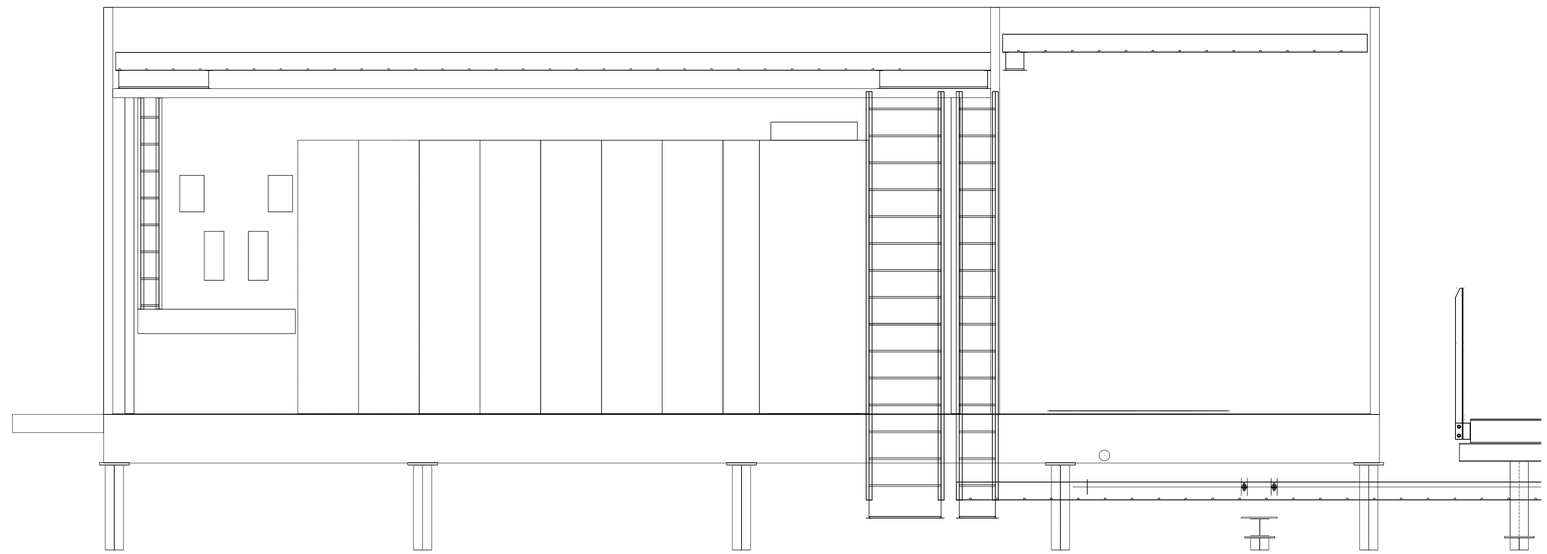

D
3111
SECTION

DWG. NO.	REFERENCE DRAWINGS	DEVON PROJECT	REV	REVISIONS	DATE (yy.mm.dd)	BY	CHK'D	APP'D	OWNR APP'D
		1011815	1	AS-BUILT (ABB BM 369267)	11.01.11	LC	DA		
		1011815	0	IFC - FIELD CONSTRUCTION (ABB BM 369267)	10.11.10	SS	DA	MJS	

ABB BER-MAC

ENGINEER AND PERMIT STAMPS

REVISION 1 "AS-BUILT"
BY: ABB BER-MAC
PREVIOUS REVISION 0
BY: ABB BER-MAC
PROFESSIONAL ENG.: M.J. SMITH
PERMIT TO PRACTICE: P7119

CADD FILE:

DESIGNED	DGA	10.07.12
DRAWN	SS	10.07.12
CHECKED		
PROCESS CK.		
MECH. CK.		
STRUCT. CK.		
ELECT. CK.		
OWNER APP.		
OWNER APP.		

devon

KOMIE
KOMIE d-87-G WELLSITE
MCC BUILDING ELECTRICAL ELEVATIONS
d-87-G/94-0-8

CONTR JOB NO	SCALE	DWG. NO.	DEVON PROJ.	
369267	1:25	D-1011815-3113	1011815	1