 

DWG. NO.	REFERENCE DRAWINGS	DEVON PROJECT	REV	REVISIONS	DATE (yy.mm.dd)	BY	CHK'D	APP'D	OWNR APP'D
		1011815	4	AS-BUILT (ABB BM 369267)	11.01.11	LC	DA		
		1011815	3	IFC - FIELD CONSTRUCTION (ABB BM 369267)	10.11.10	SS	DA	MJS	
		1011815	2	AS-BUILT - PACKAGE PREWIRE (ABB BM 369267)	10.11.02	SS	DA		
		1011815	1	IFB - FIELD CONSTRUCTION (ABB BM 369267)	10.10.21	SS	DA		
		1011815	0	IFC - PACKAGE PREWIRE (ABB BM 369267)	10.10.21	SS	DA	MJS	

ABB BER-MAC

ENGINEER AND PERMIT STAMPS

REVISION 4 "AS-BUILT"
BY: ABB BER-MAC
PREVIOUS REVISION 3
BY: ABB BER-MAC
PROFESSIONAL ENG.: M.J. SMITH
PERMIT TO PRACTICE: P7119

CADD FILE:

DESIGNED	DGA	10.07.12
DRAWN	SS	10.07.12
CHECKED		
PROCESS CK.		
MECH. CK.		
STRUCT. CK.		
ELECT. CK.		
OWNER APP.		
OWNER APP.		

devon

KOMIE
KOMIE d-87-G WELLSITE
COOLER LAYOUT
d-87-G/94-0-8

CONTR JOB NO	SCALE	DWG. NO.	DEVON PROJ.	
369267	1:30	D-1011815-3135	1011815	4